

**SDU Development Information**



Development Name:  
 FAIRVIEW WEST - STAGE 1A  
 Developer Company:  
 LIDBURY SUMMERS & WHITEMAN  
 Development Address:  
 190 CAPE HAWK DRIVE, FORSTER NSW 2428  
 Authorised Rep:  
 LEIGH MORLEY  
 Phone: 0407697757  
 E-Mail: leigh@morleigh.com.au  
 nbn Reference Number: STG-W000105249  
 Stage Number: 1A  
 Design Revision: 2

**AS - CONSTRUCTED**

**BILL OF MATERIAL**  
 NO OF LOTS: 37

PITS		DUCTS		
SIZE	QTY	SIZE	QTY	MTRS
2	9	P100	23	786.5
5	13	P50	10	244.2
6	3	P20	42	217.7
8	4			
9	0			
TOTAL NUMBER OF PITS:		29		
TOTAL NUMBER OF MANHOLES:		0		
TOTAL NUMBER OF CONDUITS:		75		
TOTAL LENGTH OF CONDUITS:		1248.4		

- PIT-ID 2** Service Drop Access Pit (650mmX280mmX565mm)
- PIT-ID 5** Network Boundary/Local Network Pit (Single Lid) (700mmX450mmX650mm)
- PIT-ID 6** Distribution/Local Network Connection Pit (Dual Lid) (1360mmX555mmX650mm)
- PIT-ID 8** Distribution/Local Network Connection Pit (1360mmX555mmX860mm)
- Shared Trench Symbol
- Transformer / Kiosk / Pad Mount Sub-station Pole Mount Transformer

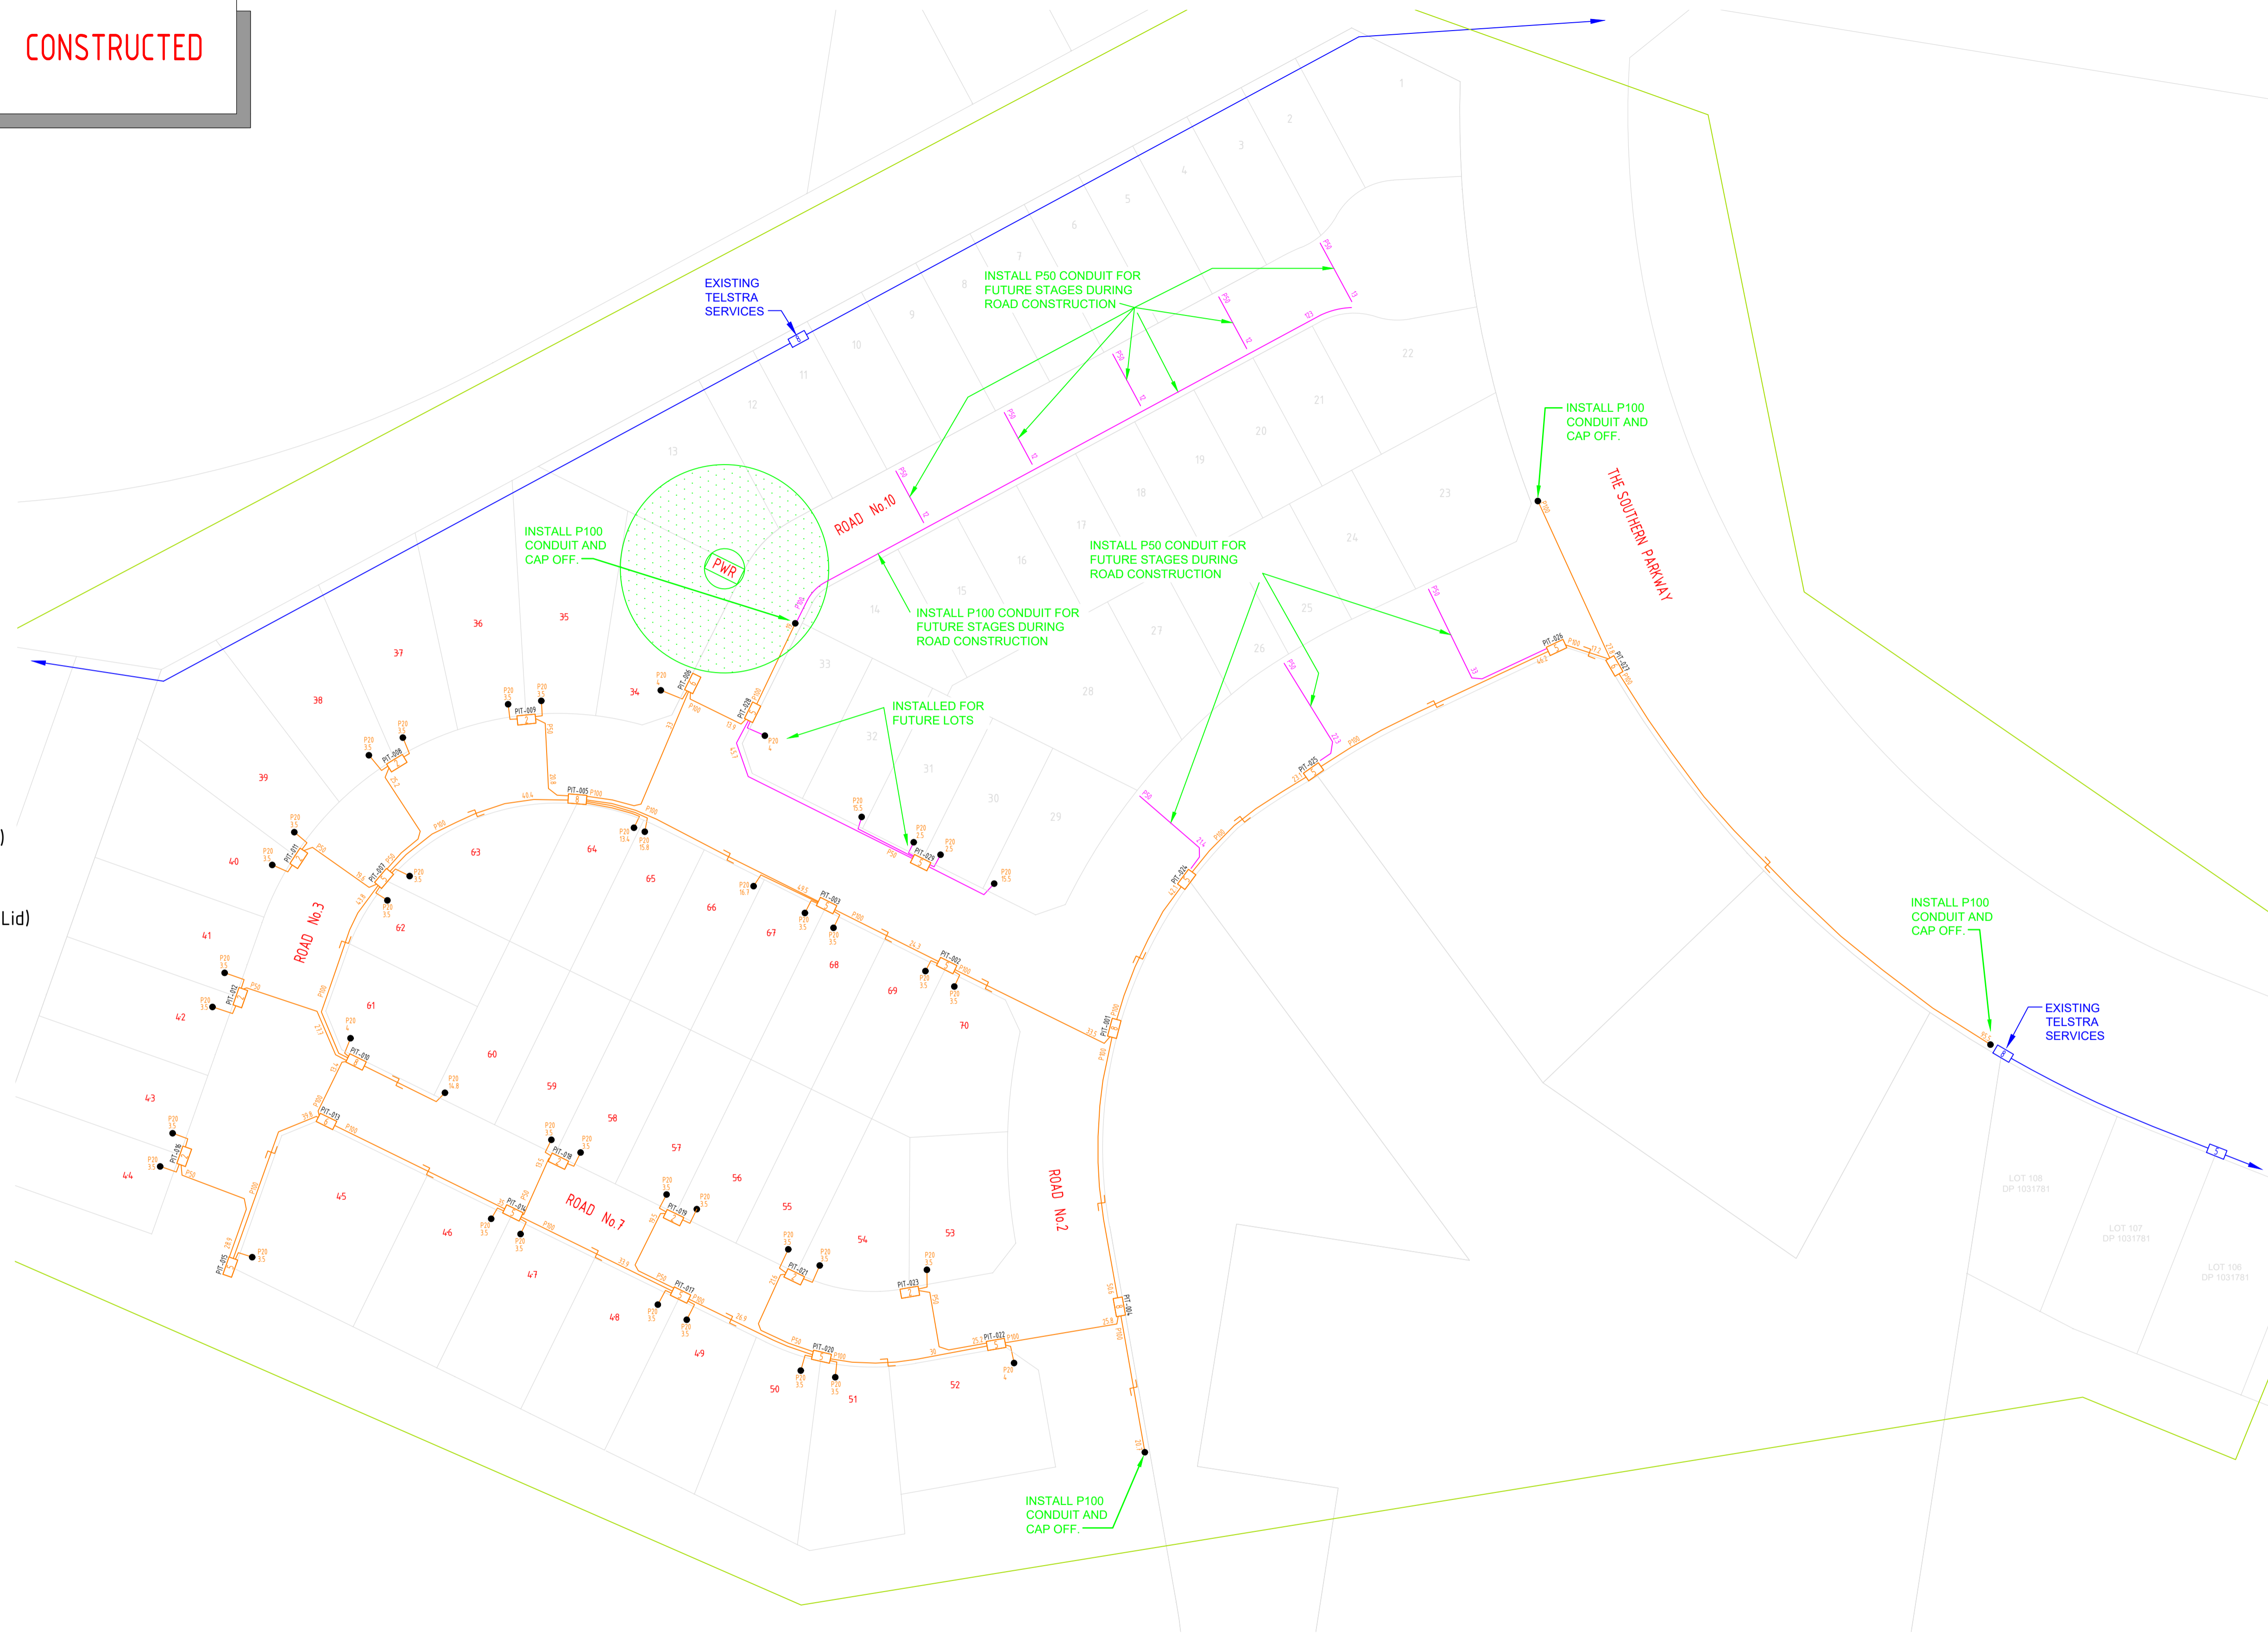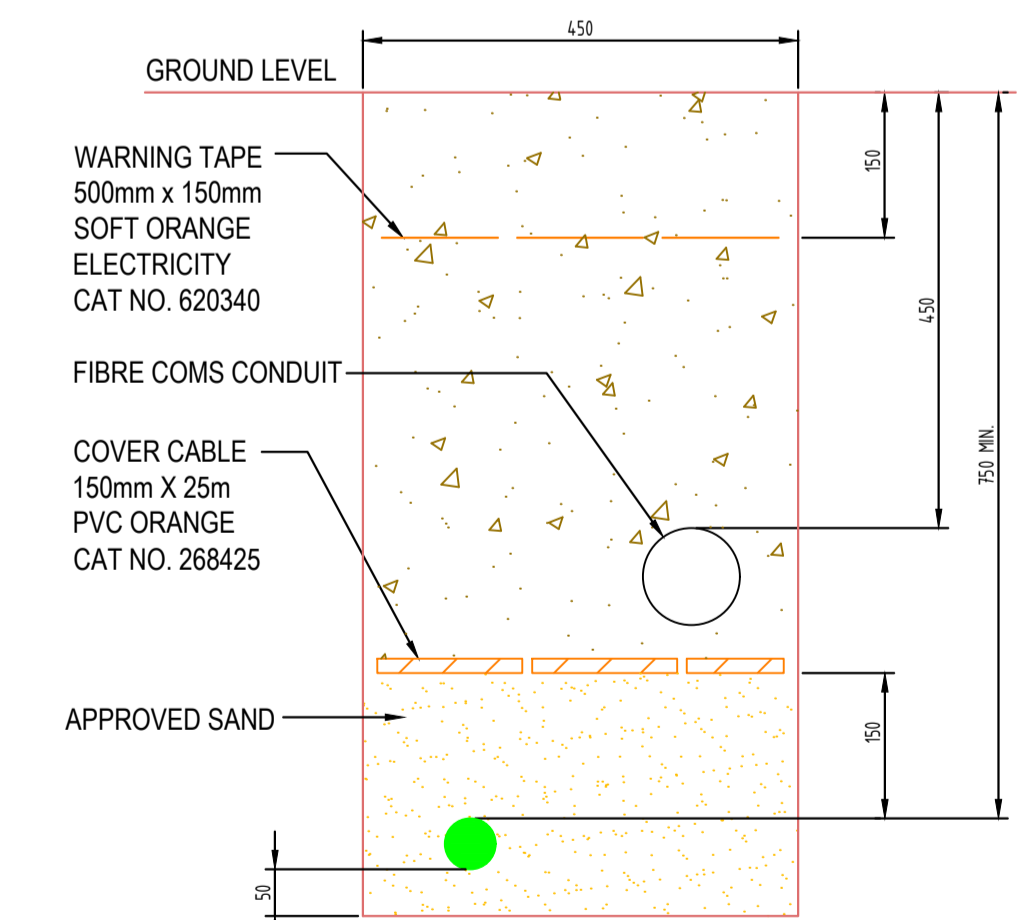

REV	DATE	DRAFTER	DESCRIPTION	APPROVED
2	17/03/22	DH	AS CONSTRUCTED	LM
1	02/03/20	DH	PRELIMINARY ISSUE FOR NBN REVIEW	LM


**STRICTLY CONFIDENTIAL**

NBNC APPROVAL RECORD:

SIGNATURE	DATE
<input type="checkbox"/> DD	_____
<input type="checkbox"/> WD	_____
<input type="checkbox"/> AB	_____

QUALITY RECORD:

NBNC DISCLAIMER  
 THIS DOCUMENT HAS BEEN PREPARED SOLELY FOR THE USE OF NBNC LIMITED (ABN 86 136 533 741) FOR USE IN MAINTAINING NBNC FACILITIES. IT HAS NOT BEEN CREATED FOR ANY OTHER USE. IT SHOULD NOT BE SCALED TO LOCATE NBNC ASSETS. NO WARRANTY IS GIVEN THAT THE INFORMATION IS ACCURATE OR COMPLETE.

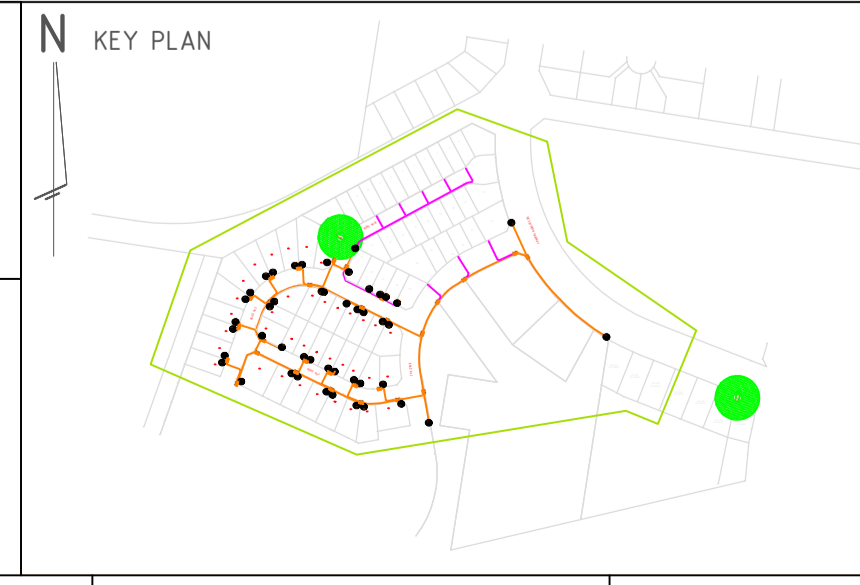

DRAWING TITLE:  
 FAIRVIEW WEST - STAGE 1A  
 SUBDIVISION OF LOT 303, DP 1099114  
 190 CAPE HAWK DRIVE, FORSTER NSW 2428

ENABLE#:

STATE: NSW	REGION:	
FSA:	SAM:	ADA:
PROJECT No: STG-W000105249		
CADREF No:		
SCALE: 1:1000	SHEET No: 1 OF 1	REV: 2